

Date: Tuesday, 15/07/2008 9:14:01 AM
 User: Julie Lecocq

Process Sheet

Customer : CU-DAR001 Dart Helicopters Services Drawing Name : FLOOR PROTECTOR AFT RH
 Job Number : 40475
 Estimate Number : 11235
 P.O. Number :
 This Issue : 15/07/2008 S.O. No. :
 Prsht Rev. : NC
 First Issue : // Type : THERMOFORMING
 Previous Run : 39997
 Written By :
 Checked & Approved By : JLD 08.15.08
 Comment : Est Rev A 04.07.01 New issue KJ/JLM
 Est Rev B 07.08.07 Thermoform in house DL
 Ext. Rev C 08.02.06 to reflect updated Dwg. DL
 Est. Rev D 08.04.15 Material Change DL

Part Number : D32814
 Drawing Number : D3281 REV. D
 Project Number : N/A
 Drawing Revision : D
 Material :
 Due Date : 30/07/2008 Qty: 10 Um: Each

Additional Product

Job Number:



Seq. #: Machine Or Operation: Description :

1.0 MLEXS093F600602 GE PLASTICS LEXAN SHEET



Comment: Qty.: 4.3330 sf(s)/Unit Total : 43.3300 sf(s)
 GE PLASTICS LEXAN SHEET

Material Batch Number BB 1106251

2.0 HAND FINISH TH HAND FINISHING THERMOFORMING



Comment: HAND FINISHING THERMOFORMING

1) Cut Blanks

08/07/16

X10

BB

3.0 THERMOFORMING THERMOFORMING MACHINE



Comment: THERMOFORMING MACHINE

Thermoform as per Dwg. D32811 and Folio FTA 010

Dwg. Rev. D

Folio Rev. BB 08/07/21

BB 08/07/21 X10

4.0 QC2 INSPECT PARTS AS THEY COME OFF MACHINE



Comment: INSPECT PARTS AS THEY COME OFF MACHINE

W/O:		WORK ORDER CHANGES					
DATE	STEP	PROCEDURE CHANGE	By	Date	Qty	Approval Chief Eng / Prod Mgr	Approval QC Inspector

Part No: _____ PAR #: _____ Fault Category: _____ NCR: Yes No DQA: _____ Date: _____

QA: N/C Closed: _____ Date: _____

NCR:		WORK ORDER NON-CONFORMANCE (NCR)						
DATE	STEP	Description of NC Section A	Corrective Action Section B			Verification Section C	Approval Chief Eng	Approval QC Inspector
			Initial Chief Eng	Action Description Chief Eng	Sign & Date			

NOTE: Date & initial all entries

Date: Tuesday, 15/07/2008 9:14:01 AM
User: Julie Lecocq

Process Sheet

Customer: CU-DAR001 Dart Helicopters Services

Drawing Name: FLOOR PROCTOR AFT RH

Job Number: 40475

Part Number: D32814

Job Number:



Seq. #:

Machine Or Operation:

Description :

5.0

HAND FINISH TH

HAND FINISHING THERMOFORMING



Comment: HAND FINISHING THERMOFORMING

1) Trim to Finished Dimensions

B 08/07/21 X 10

6.0

QC2

INSPECT PARTS AS THEY COME OFF MACHINE



Comment: INSPECT PARTS AS THEY COME OFF MACHINE

1) Check Surface finish for undesired marks, voids, dimples etc.

2) Check dimensions to ensure conformity to drawing tolerances.

B 08/07/21 X 10

7.0

QC5

INSPECT WORK TO CURRENT STEP



Comment: INSPECT WORK TO CURRENT STEP

S 08/07/22 @

8.0

PACKAGING 1

PACKAGING RESOURCE #1



Comment: PACKAGING RESOURCE #1

10 8/7/22 (10)

9.0

QC21

FINAL INSPECTION/W/O RELEASE



Comment: FINAL INSPECTION/W/O RELEASE

08/07/22

Job Completion



mf 08-07-22

W/O:		WORK ORDER CHANGES					
DATE	STEP	PROCEDURE CHANGE	By	Date	Qty	Approval Chief Eng / Prod Mgr	Approval QC Inspector

Part No: _____ PAR #: _____ Fault Category: _____ NCR: Yes No DQA: _____ Date: _____

QA: N/C Closed: _____ Date: _____

NCR:		WORK ORDER NON-CONFORMANCE (NCR)						
DATE	STEP	Description of NC Section A	Corrective Action Section B			Verification Section C	Approval Chief Eng	Approval QC Inspector
			Initial Chief Eng	Action Description Chief Eng	Sign & Date			

NOTE: Date & initial all entries

DART AEROSPACE LTD		Work Order: 40475
Description: Floor Protector, Aft RH		Part Number: D3281-4
Inspection Dwg: D3281	Rev: D	Page 1 of 1

FIRST ARTICLE INSPECTION CHECKLIST

☒ First Article ☐ Prototype

THERMOFORMING SECTION

Description	Accept	Reject	Method of Inspection	Comments
Inside Radii less than 0.1875"	✓			
Shape Definition	✓			
Texture Retention	✓			
Material imperfections such as bumps, cracks, voids, scratching	✓			


Measured by: BB	Date: 08/07/17
-----------------	----------------

TRIMMING SECTION

Drawing Dimension	Tolerance	Actual Dimension	Accept	Reject	Method of Inspection	Comments
17.8	+/-0.100	17.85	✓			
17.1	+/-0.100	17.125	✓			
14.3	+/-0.100	14.3	✓			
0.95	+/-0.030	.958	✓			
0.25	+/-0.030	.24	✓			
3.1	+/-0.100	3.1	✓			
0.050	Min	.61	✓			
0.070	Min	.78	✓			

Measured by: BB	Date: 08/07/17
Audited by: PH	Date: 08.07.17
Prototype Approval: N/A	Date: N/A

Rev	Date	Change	Revised by	Approved
A	08.02.28	New Issue	KJ/DL	
B	08.04.16	Dimensions updated per Dwg Rev D	KJ/DL	

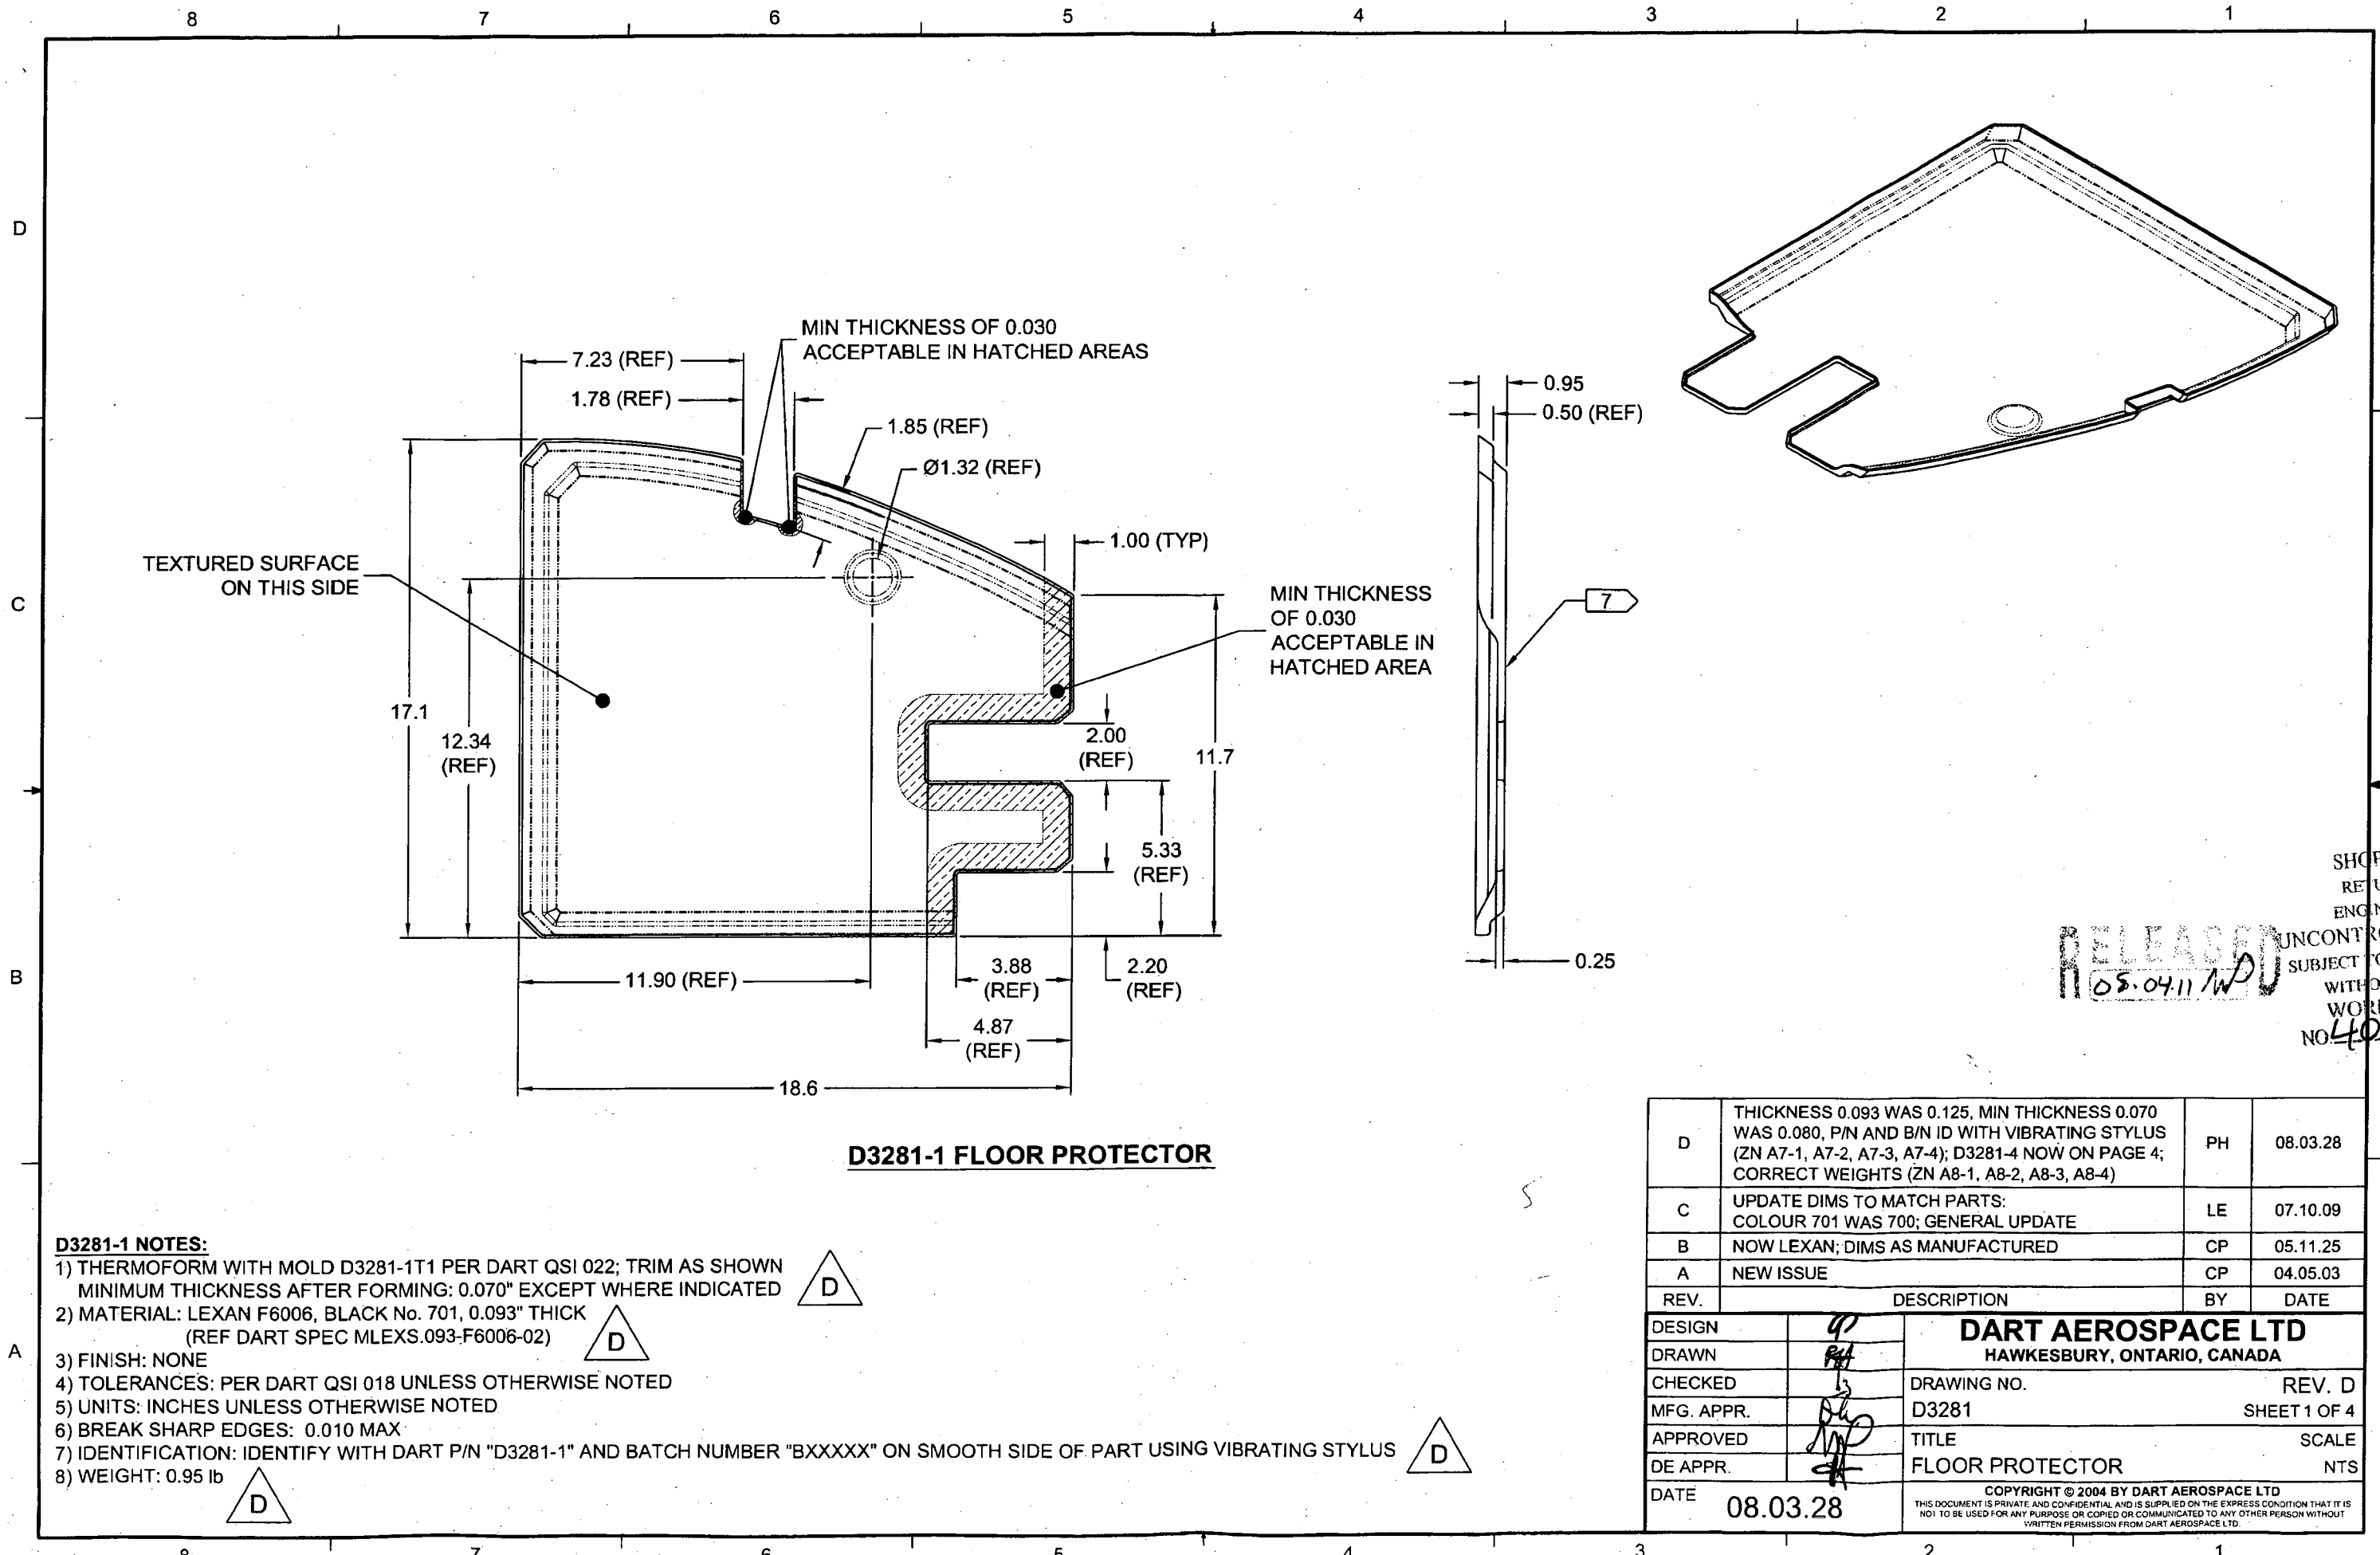

D3281-1 FLOOR PROTECTOR




D3281-1 NOTES:

- 1) THERMOFORM WITH MOLD D3281-1T1 PER DART QSI 022; TRIM AS SHOWN
MINIMUM THICKNESS AFTER FORMING: 0.070" EXCEPT WHERE INDICATED
- 2) MATERIAL: LEXAN F6006, BLACK No. 701, 0.093" THICK
(REF DART SPEC MLEXS.093-F6006-02)
- 3) FINISH: NONE
- 4) TOLERANCES: PER DART QSI 018 UNLESS OTHERWISE NOTED
- 5) UNITS: INCHES UNLESS OTHERWISE NOTED
- 6) BREAK SHARP EDGES: 0.010 MAX
- 7) IDENTIFICATION: IDENTIFY WITH DART P/N "D3281-1" AND BATCH NUMBER "BXXXXX" ON SMOOTH SIDE OF PART USING VIBRATING STYLUS
- 8) WEIGHT: 0.95 lb

D	THICKNESS 0.093 WAS 0.125, MIN THICKNESS 0.070 WAS 0.080, P/N AND B/N ID WITH VIBRATING STYLUS (ZN A7-1, A7-2, A7-3, A7-4); D3281-4 NOW ON PAGE 4; CORRECT WEIGHTS (ZN A8-1, A8-2, A8-3, A8-4)	PH	08.03.28
C	UPDATE DIMS TO MATCH PARTS: COLOUR 701 WAS 700; GENERAL UPDATE	LE	07.10.09
B	NOW LEXAN; DIMS AS MANUFACTURED	CP	05.11.25
A	NEW ISSUE	CP	04.05.03
REV.	DESCRIPTION	BY	DATE
DESIGN	47	DART AEROSPACE LTD HAWKESBURY, ONTARIO, CANADA	
DRAWN	PH		
CHECKED	3	DRAWING NO.	REV. D
MFG. APPR.	PH	D3281	SHEET 1 OF 4
APPROVED	PH	TITLE	SCALE
DE APPR.	PH	FLOOR PROTECTOR	NTS
DATE	08.03.28	COPYRIGHT © 2004 BY DART AEROSPACE LTD THIS DOCUMENT IS PRIVATE AND CONFIDENTIAL AND IS SUPPLIED ON THE EXPRESS CONDITION THAT IT IS NOT TO BE USED FOR ANY PURPOSE OR COPIED OR COMMUNICATED TO ANY OTHER PERSON WITHOUT WRITTEN PERMISSION FROM DART AEROSPACE LTD.	

SHOP COPY
RETURN TO
ENGINEERING
UNCONTROLLED COPY
SUBJECT TO AMENDMENT
WITHOUT NOTICE
WORK ORDER
NO. 40475

TEXTURED SURFACE
ON THIS SIDE

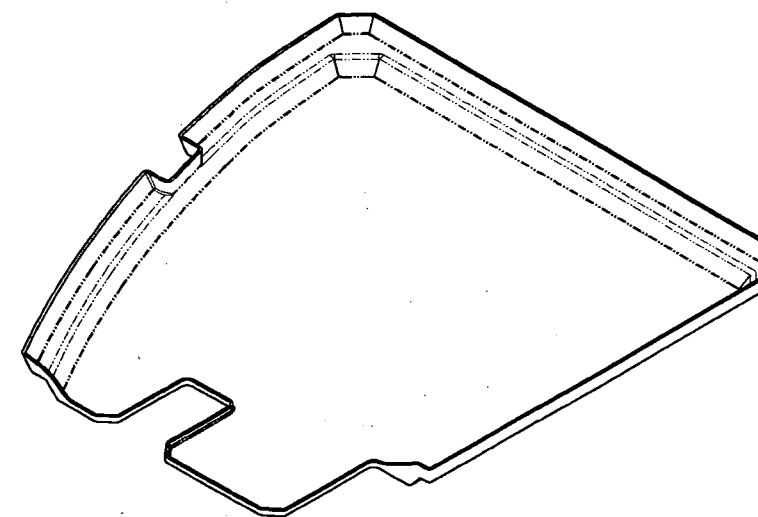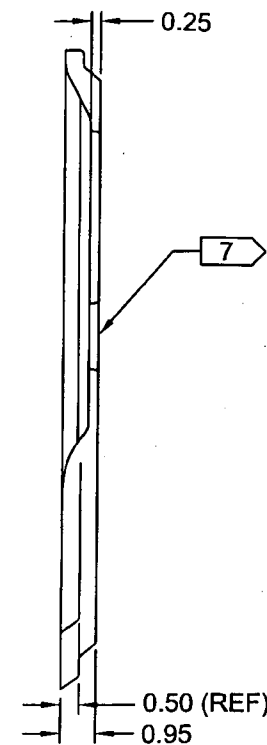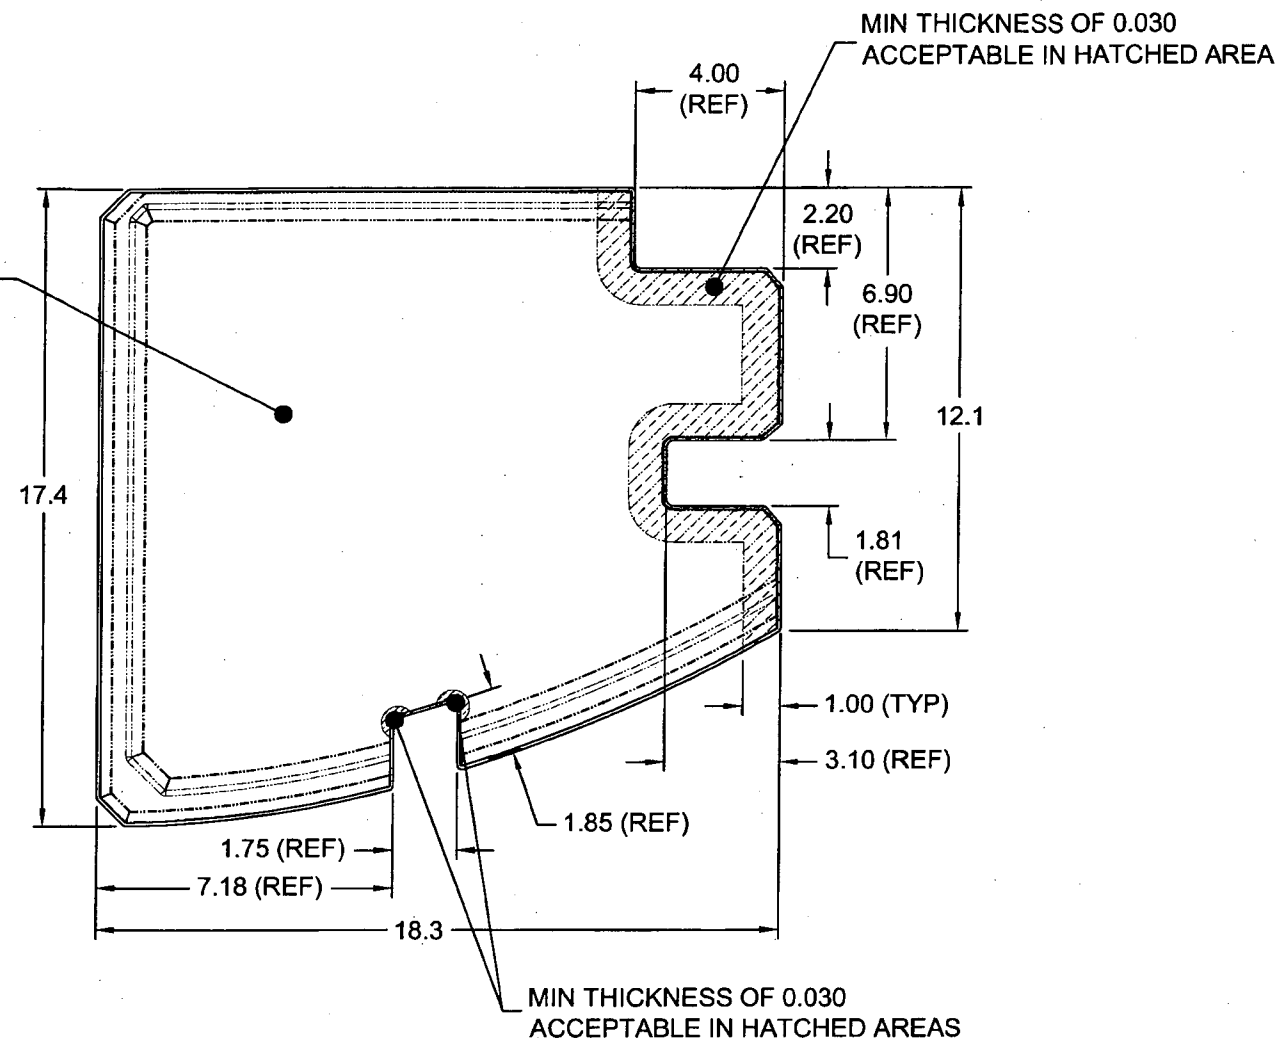




D3281-2 FLOOR PROTECTOR

D3281-2 NOTES:

- 1) THERMOFORM WITH MOLD D3281-2T1 PER DART QSI 022; TRIM AS SHOWN
MINIMUM THICKNESS AFTER FORMING: 0.070" EXCEPT WHERE INDICATED
- 2) MATERIAL: LEXAN F6006, BLACK No. 701, 0.093" THICK
(REF DART SPEC MLEXS.093-F6006-02)
- 3) FINISH: NONE
- 4) TOLERANCES: PER DART QSI 018 UNLESS OTHERWISE NOTED
- 5) UNITS: INCHES UNLESS OTHERWISE NOTED
- 6) BREAK SHARP EDGES: 0.010 MAX
- 7) IDENTIFICATION: IDENTIFY WITH DART P/N "D3281-2" AND BATCH NUMBER "BXXXXX" ON SMOOTH SIDE OF PART USING VIBRATING STYLUS
- 8) WEIGHT: 0.97 lb

SHOP COPY
RETURN TO
ENGINEERING
UNCONTROLLED COPY
SUBJECT TO AMENDMENT
WITHOUT NOTICE
WORK ORDER
NO. 40475

DESIGN		DART AEROSPACE LTD	
DRAWN		HAWKESBURY, ONTARIO, CANADA	
CHECKED		DRAWING NO.	REV. D
MFG. APPR.		D3281	SHEET 2 OF 4
APPROVED		TITLE	SCALE
DE APPR.		FLOOR PROTECTOR	NTS
DATE	08.03.28	<small>COPYRIGHT © 2004 BY DART AEROSPACE LTD THIS DOCUMENT IS PRIVATE AND CONFIDENTIAL AND IS SUPPLIED ON THE EXPRESS CONDITION THAT IT IS NOT TO BE USED FOR ANY PURPOSE OR COPIED OR COMMUNICATED TO ANY OTHER PERSON WITHOUT WRITTEN PERMISSION FROM DART AEROSPACE LTD.</small>	

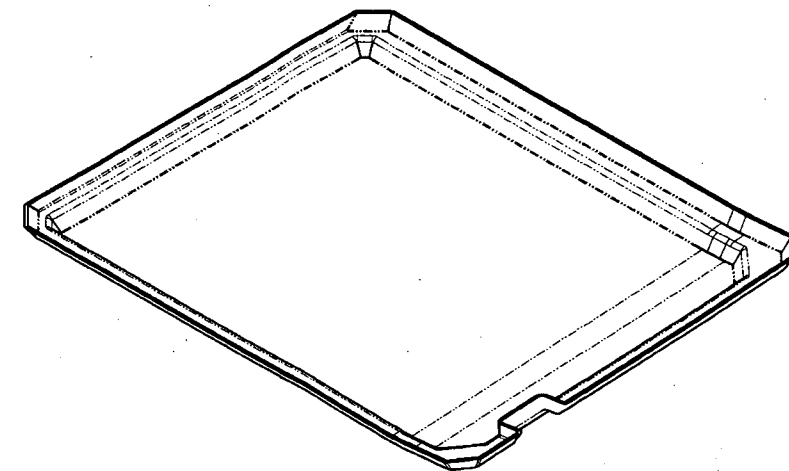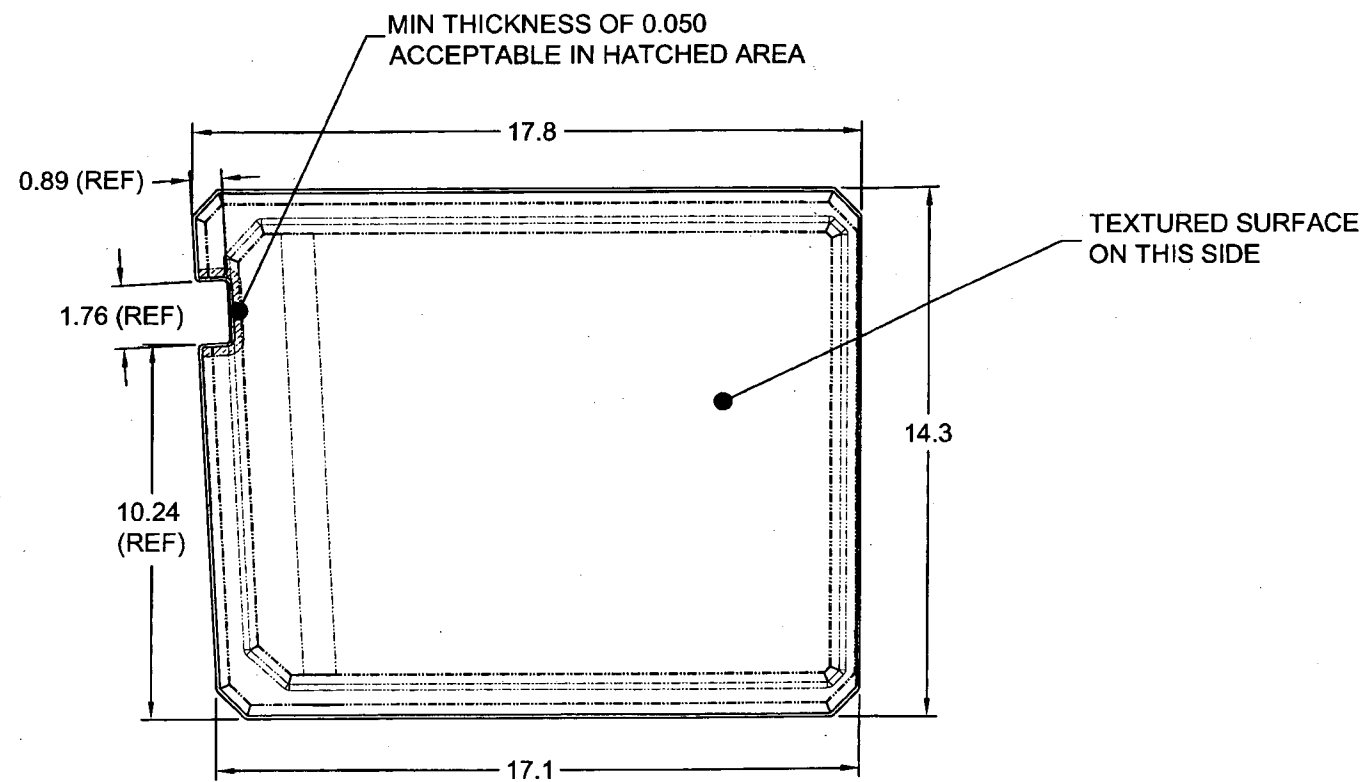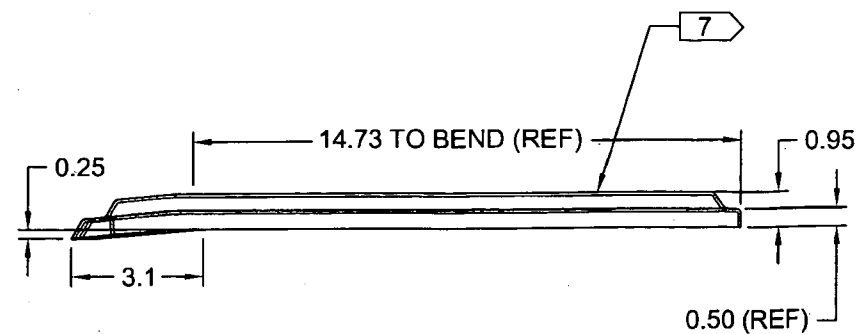

D3281-3 FLOOR PROTECTOR

D3281-3 NOTES:

- 1) THERMOFORM WITH MOLD D3281-3T1 PER DART QSI 022; TRIM AS SHOWN
MINIMUM THICKNESS AFTER FORMING: 0.070" EXCEPT WHERE INDICATED
- 2) MATERIAL: LEXAN F6006, BLACK No. 701, 0.093" THICK
(REF DART SPEC MLEXS.093-F6006-02)
- 3) FINISH: NONE
- 4) TOLERANCES: PER DART QSI 018 UNLESS OTHERWISE NOTED
- 5) UNITS: INCHES UNLESS OTHERWISE NOTED
- 6) BREAK SHARP EDGES: 0.010 MAX
- 7) IDENTIFICATION: IDENTIFY WITH DART P/N "D3281-3" AND BATCH NUMBER "BXXXXX" ON SMOOTH SIDE OF PART USING VIBRATING STYLUS
- 8) WEIGHT: 0.87 lb



RELEASED
08-04-11

SHOP COPY
RETURN TO
ENGINEERING
UNCONTROLLED COPY
SUBJECT TO AMENDMENT
WITHOUT NOTICE
WORK ORDER
NO. 40475

DESIGN	90	DART AEROSPACE LTD	
DRAWN	RF	HAWKESBURY, ONTARIO, CANADA	
CHECKED		DRAWING NO.	REV. D
MFG. APPR.		D3281	SHEET 3 OF 4
APPROVED		TITLE	SCALE
DE APPR.		FLOOR PROTECTOR	NTS
DATE	08.03.28	<small>COPYRIGHT © 2004 BY DART AEROSPACE LTD THIS DOCUMENT IS PRIVATE AND CONFIDENTIAL AND IS SUPPLIED ON THE EXPRESS CONDITION THAT IT IS NOT TO BE USED FOR ANY PURPOSE OR COPIED OR COMMUNICATED TO ANY OTHER PERSON WITHOUT WRITTEN PERMISSION FROM DART AEROSPACE LTD.</small>	

8

7

6

5

4



3

2

1


D

D

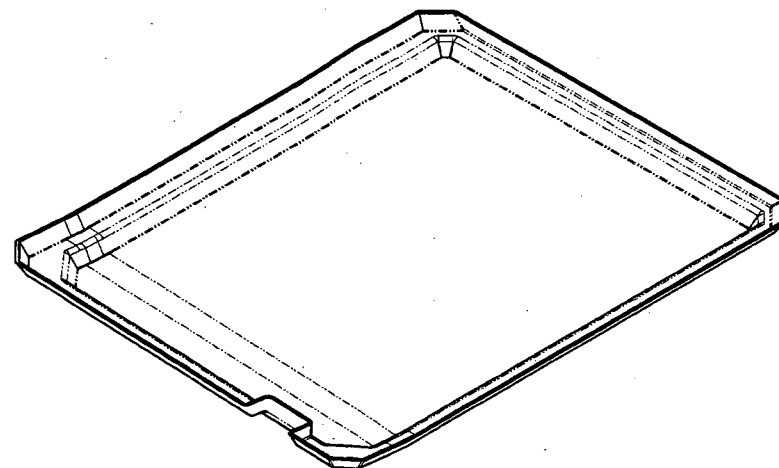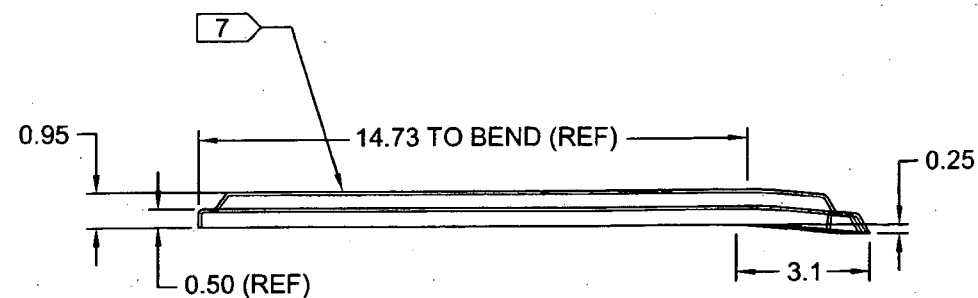

MIN THICKNESS OF 0.050
ACCEPTABLE IN HATCHED AREA

TEXTURED SURFACE
ON THIS SIDE

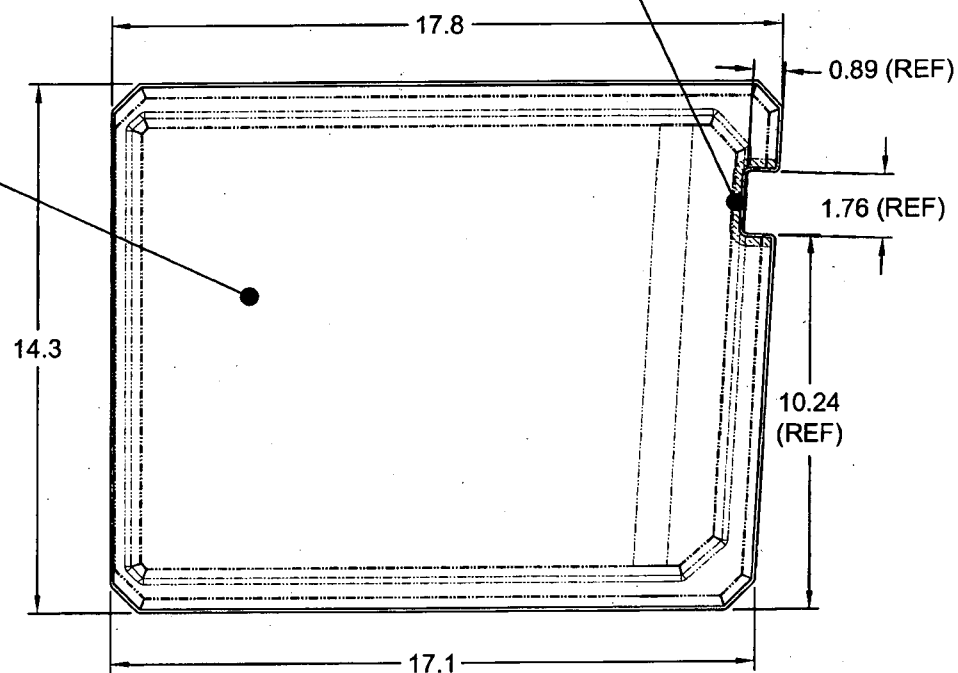

D3281-4 FLOOR PROTECTOR

D3281-4 NOTES:

- 1) THERMOFORM WITH MOLD D3281-4T1 PER DART QSI 022; TRIM AS SHOWN
MINIMUM THICKNESS AFTER FORMING: 0.070" EXCEPT WHERE INDICATED
- 2) MATERIAL: LEXAN F6006, BLACK No. 701, 0.093" THICK
(REF DART SPEC MLEXS.093-F6006-02)
- 3) FINISH: NONE
- 4) TOLERANCES: PER DART QSI 018 UNLESS OTHERWISE NOTED
- 5) UNITS: INCHES UNLESS OTHERWISE NOTED
- 6) BREAK SHARP EDGES: 0.010 MAX
- 7) IDENTIFICATION: IDENTIFY WITH DART P/N "D3281-4" AND BATCH NUMBER "BXXXXX" ON SMOOTH SIDE OF PART USING VIBRATING STYLUS
- 8) WEIGHT: 0.87 lb



SHOP COPY
RETURN TO
ENGINEERING
UNCONTROLLED COPY
SUBJECT TO AMENDMENT
WITHOUT NOTICE
WORK ORDER
NO. 40975

DESIGN	92	DART AEROSPACE LTD	
DRAWN	RH	HAWKESBURY, ONTARIO, CANADA	
CHECKED		DRAWING NO.	REV. D
MFG. APPR.		D3281	SHEET 4 OF 4
APPROVED		TITLE	SCALE
DE APPR.		FLOOR PROTECTOR	NTS
DATE	08.03.28	COPYRIGHT © 2004 BY DART AEROSPACE LTD	
THIS DOCUMENT IS PRIVATE AND CONFIDENTIAL AND IS SUPPLIED ON THE EXPRESS CONDITION THAT IT IS NOT TO BE USED FOR ANY PURPOSE OR COPIED OR COMMUNICATED TO ANY OTHER PERSON WITHOUT WRITTEN PERMISSION FROM DART AEROSPACE LTD.			

A